


EXISTING CONDITIONS SURVEY

Building Survey Company:

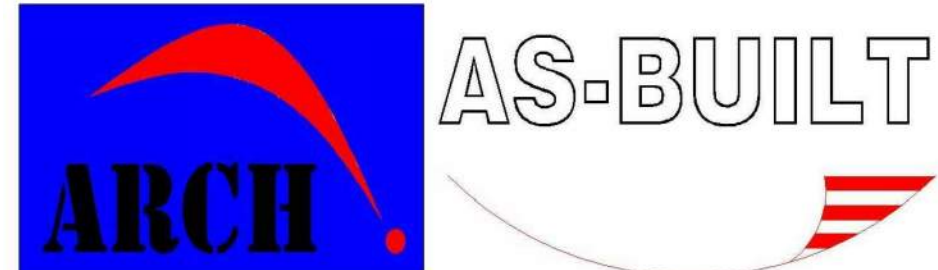

Survey & CAD Designing
Tel: 917.400.3011
Email: archasbuilt@gmail.com
www.archasbuilt.com




Existing Fire Sprinkler System

139 Highway 35, Old Bridge NJ 07735

Client:
ACTIVE FIRE PROTECTION
INC.

26 Ruzhin Road, #301, Monroe NY 10950
Tel: 845.782.7494 Fax: 845.782.7495

www.afpfiresprinkler.com

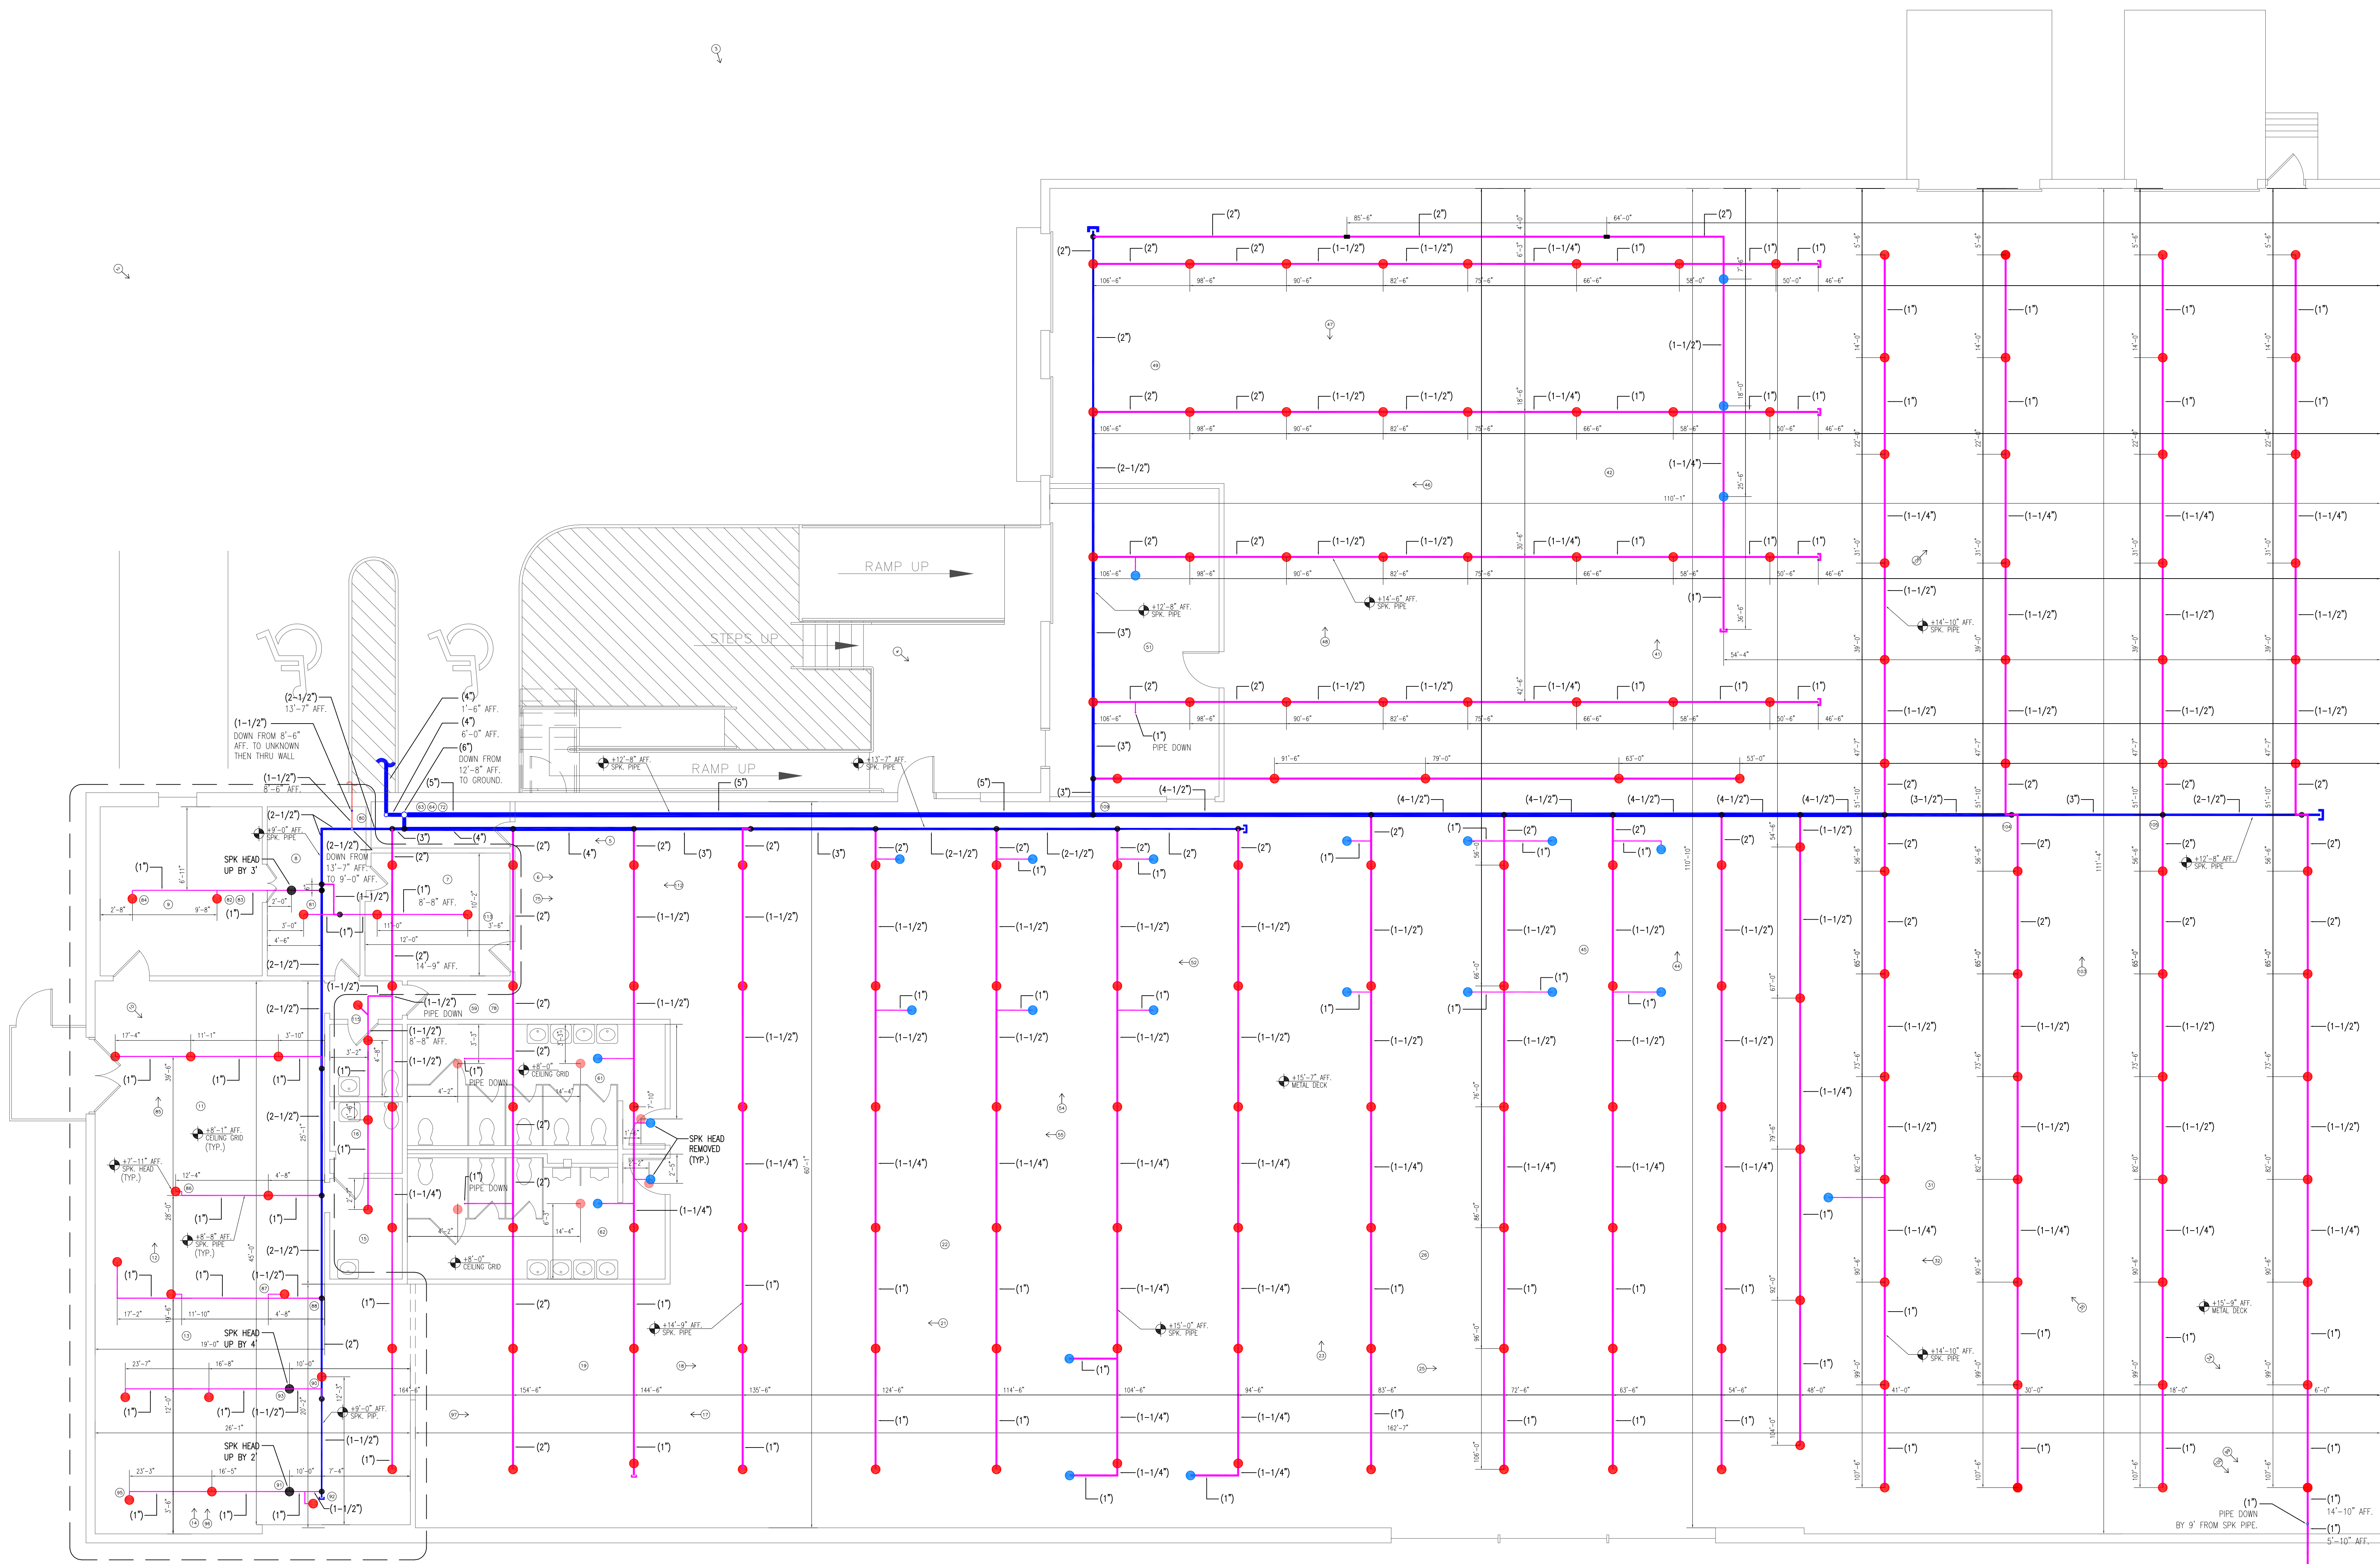

ARCH AS-BUILT
Survey + CAD Designing
Tel: 917-400-3011
archasbuilt@gmail.com
www.archasbuilt.com

DATE: 04/24/18
SURVEYED BY: IBRAHIM ISMATI
PROJECT NO: 18.0424
SCALE: N.T.S.
SHEET TITLE:

EXISTING FIRE SPRINKLER
SYSTEM

SHEET NO:

SP-01