


EXISTING CONDITIONS SURVEY

Building Survey Company:

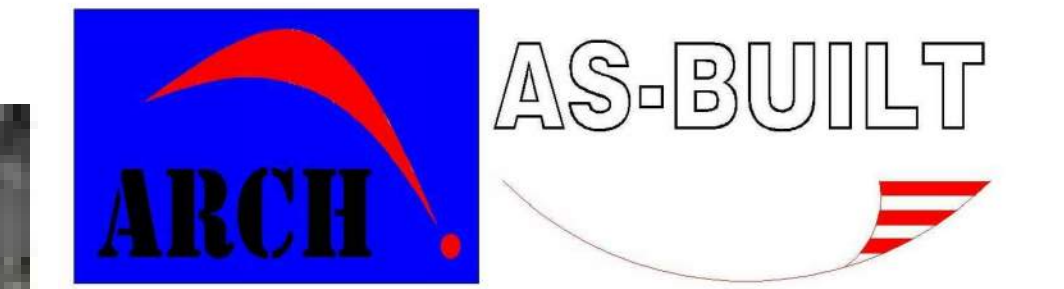

Survey & CAD Designing

Tel: 917.400.3011

Email: archasbuilt@gmail.com

www.archasbuilt.com

Client:


**ACTIVE FIRE PROTECTION
INC.**

26 Ruzhin Road, #301, Monroe NY 10950
Tel: 845.782.7494 Fax: 845.782.7495

www.afpfiresprinkler.com

Existing Fire Sprinkler System

360 Route 211 E Middletown NY 10940

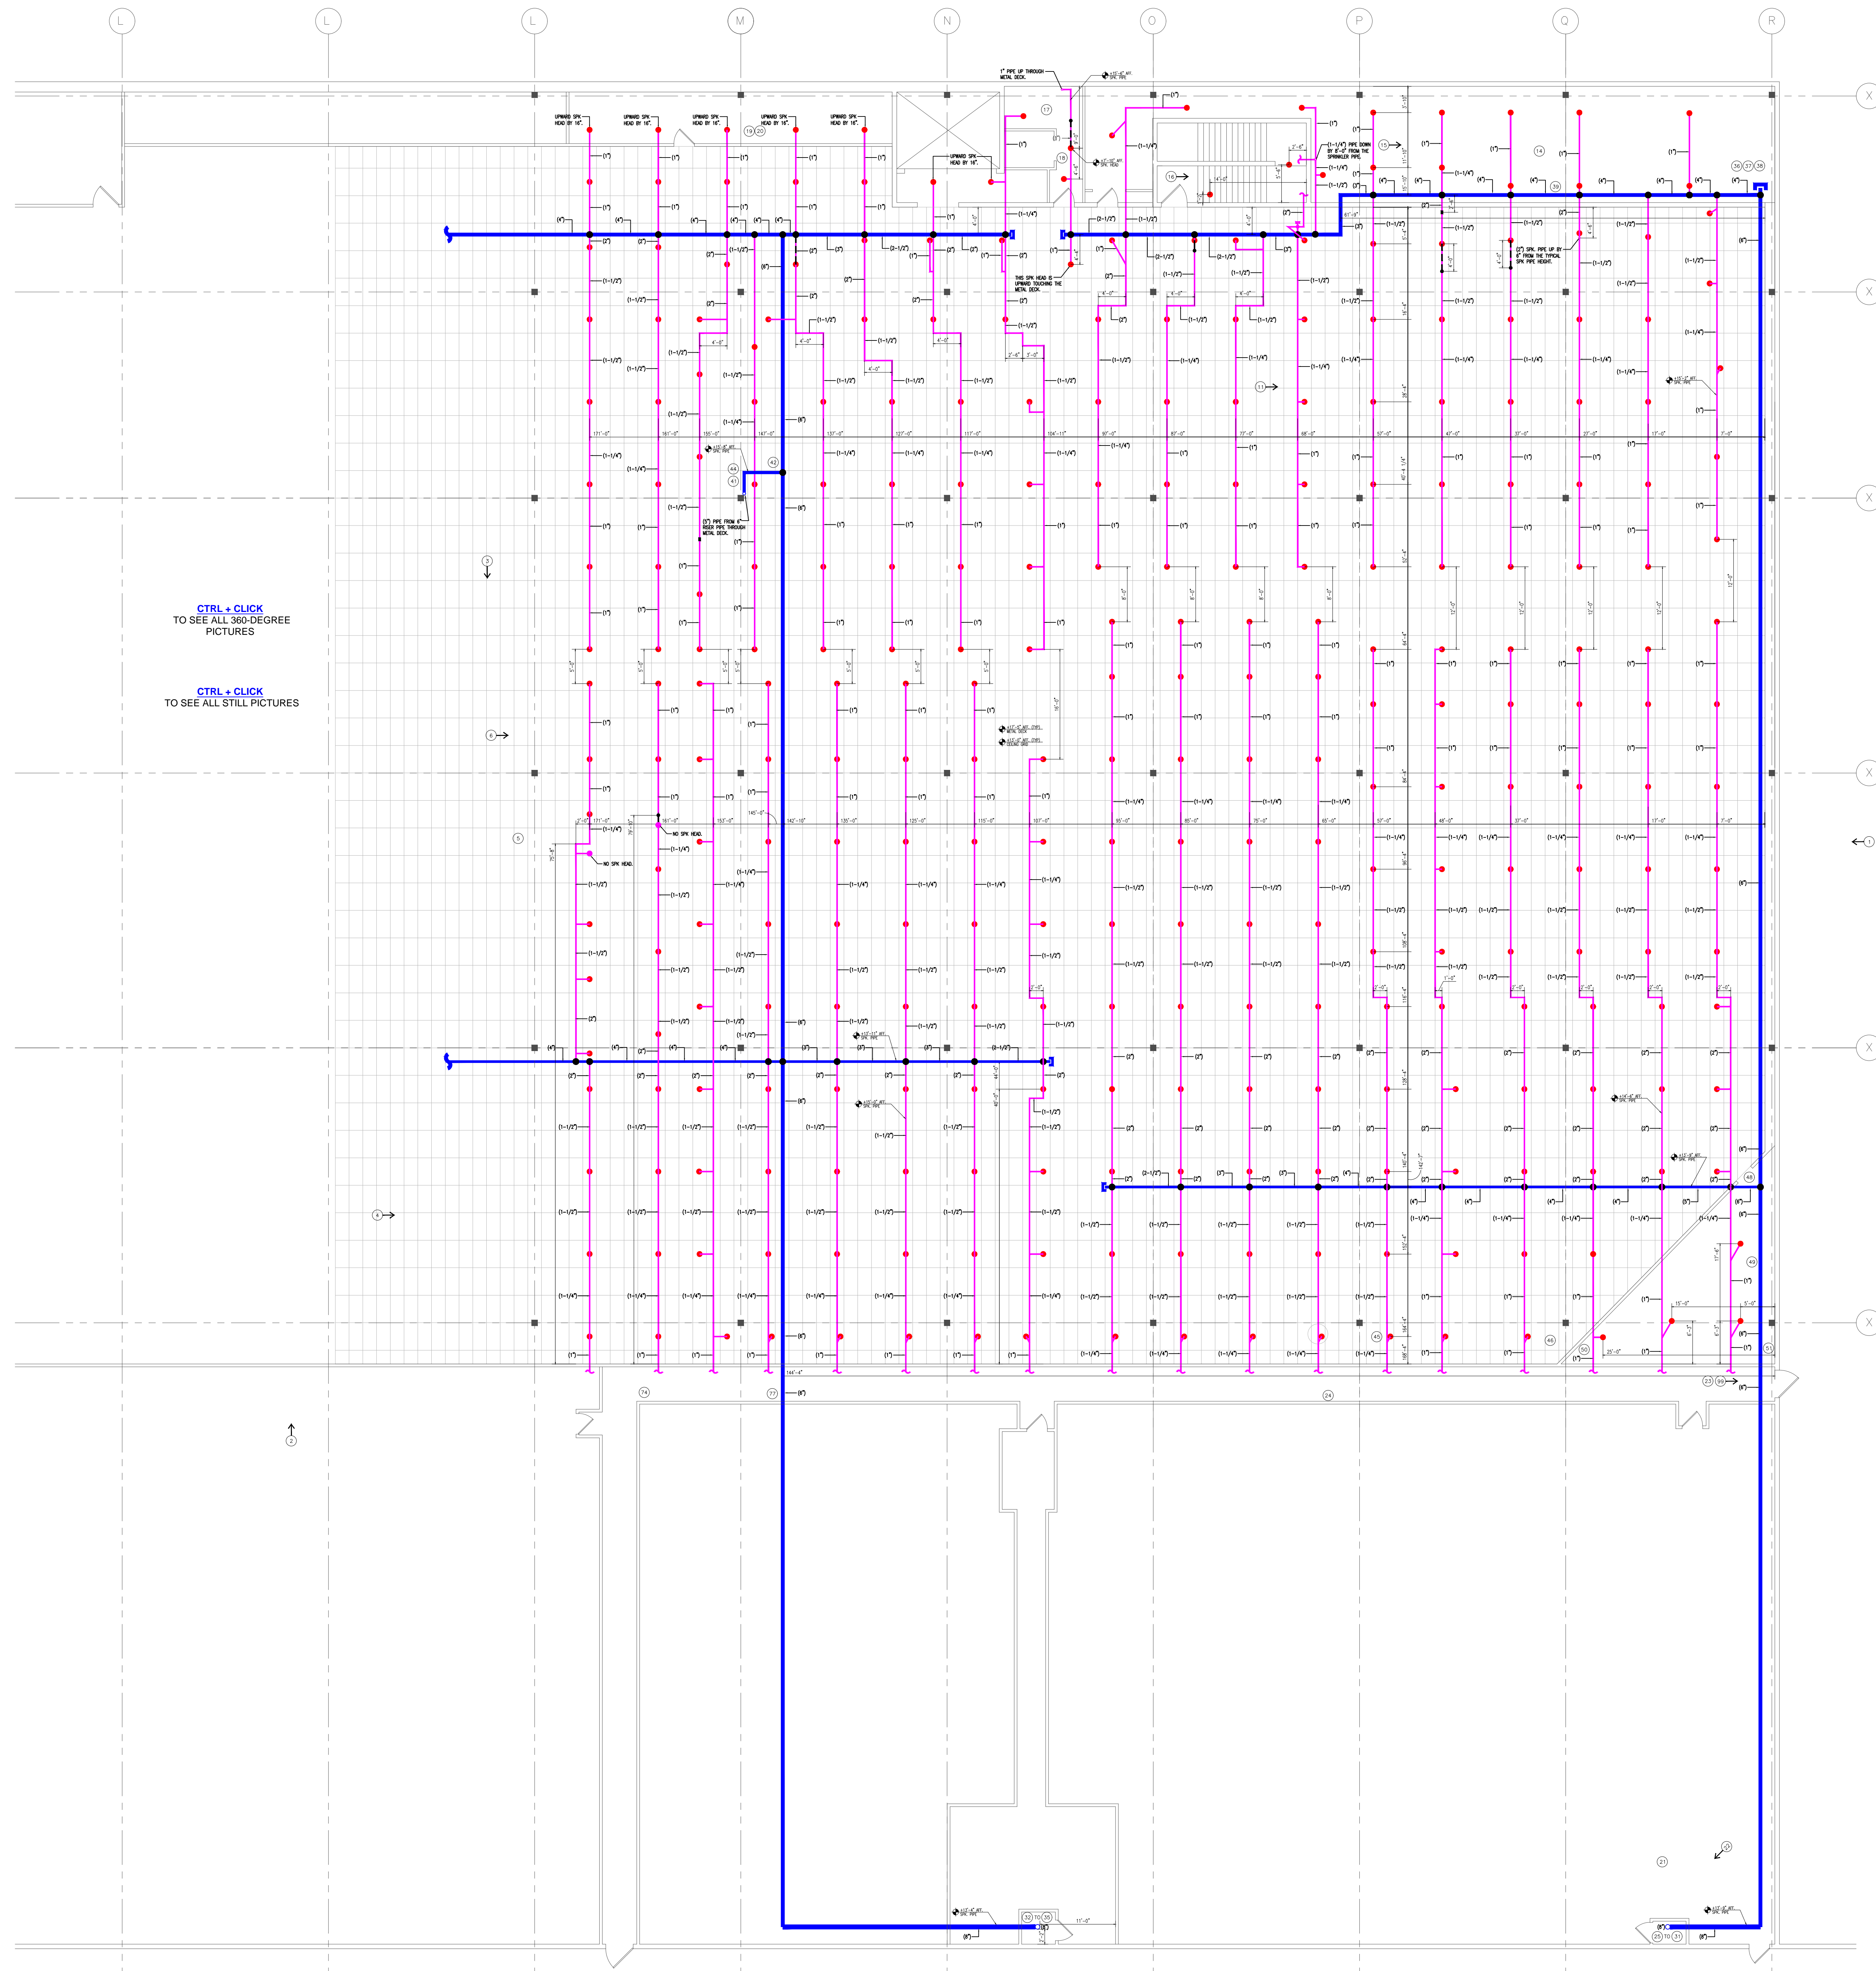

CTRL + CLICK
TO SEE ALL 360-DEGREE
PICTURES

CTRL + CLICK
TO SEE ALL STILL PICTURES

ARCH AS-BUILT
Survey + CAD Designing

Tel: 917-400-3011
archasbuilt@gmail.com
www.archasbuilt.com

DATE: 07/23/18
SURVEYED BY: IBRAHIM ISMATI
PROJECT NO: 18.0723
SCALE: N.T.S.
SHEET TITLE:

EXISTING FIRE SPRINKLER
SYSTEM PLANS

SHEET NO:

SP-01