


**EXISTING
CONDITIONS
SURVEY**

Building Survey Company:

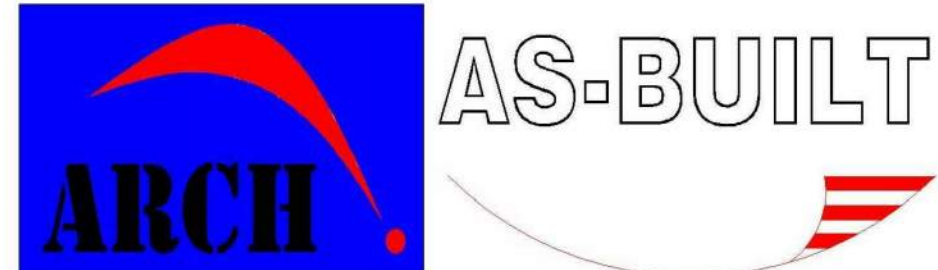

Survey & CAD Designing
Tel: 917.400.3011
Email: archasbuilt@gmail.com
www.archasbuilt.com



Existing Fire Sprinkler System

500 Franklin Turnpike, Ramsey NJ 07446

Client:
**ACTIVE FIRE PROTECTION
INC.**

26 Ruzhin Road, #301, Monroe NY 10950
Tel: 845.782.7494 Fax: 845.782.7495

www.afpfiresprinkler.com

