


EXISTING CONDITIONS SURVEY

Building Survey Company:

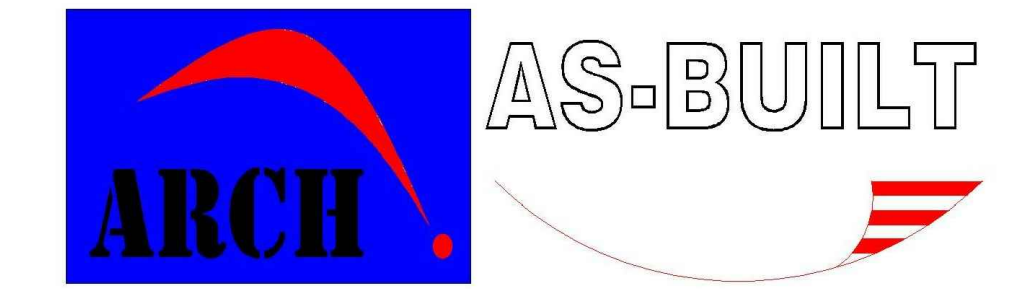

Survey & CAD Designing

Tel: 917.400.3011

Email: archasbuilt@gmail.com

www.archasbuilt.com




Client:

ACTIVE FIRE PROTECTION
INC.

26 Ruzhin Road, #301, Monroe NY 10950
Tel: 845.782.7494 Fax: 845.782.7495

www.afpfiresprinkler.com

747 Chestnut Rd, Chestnut Ridge NY 10977

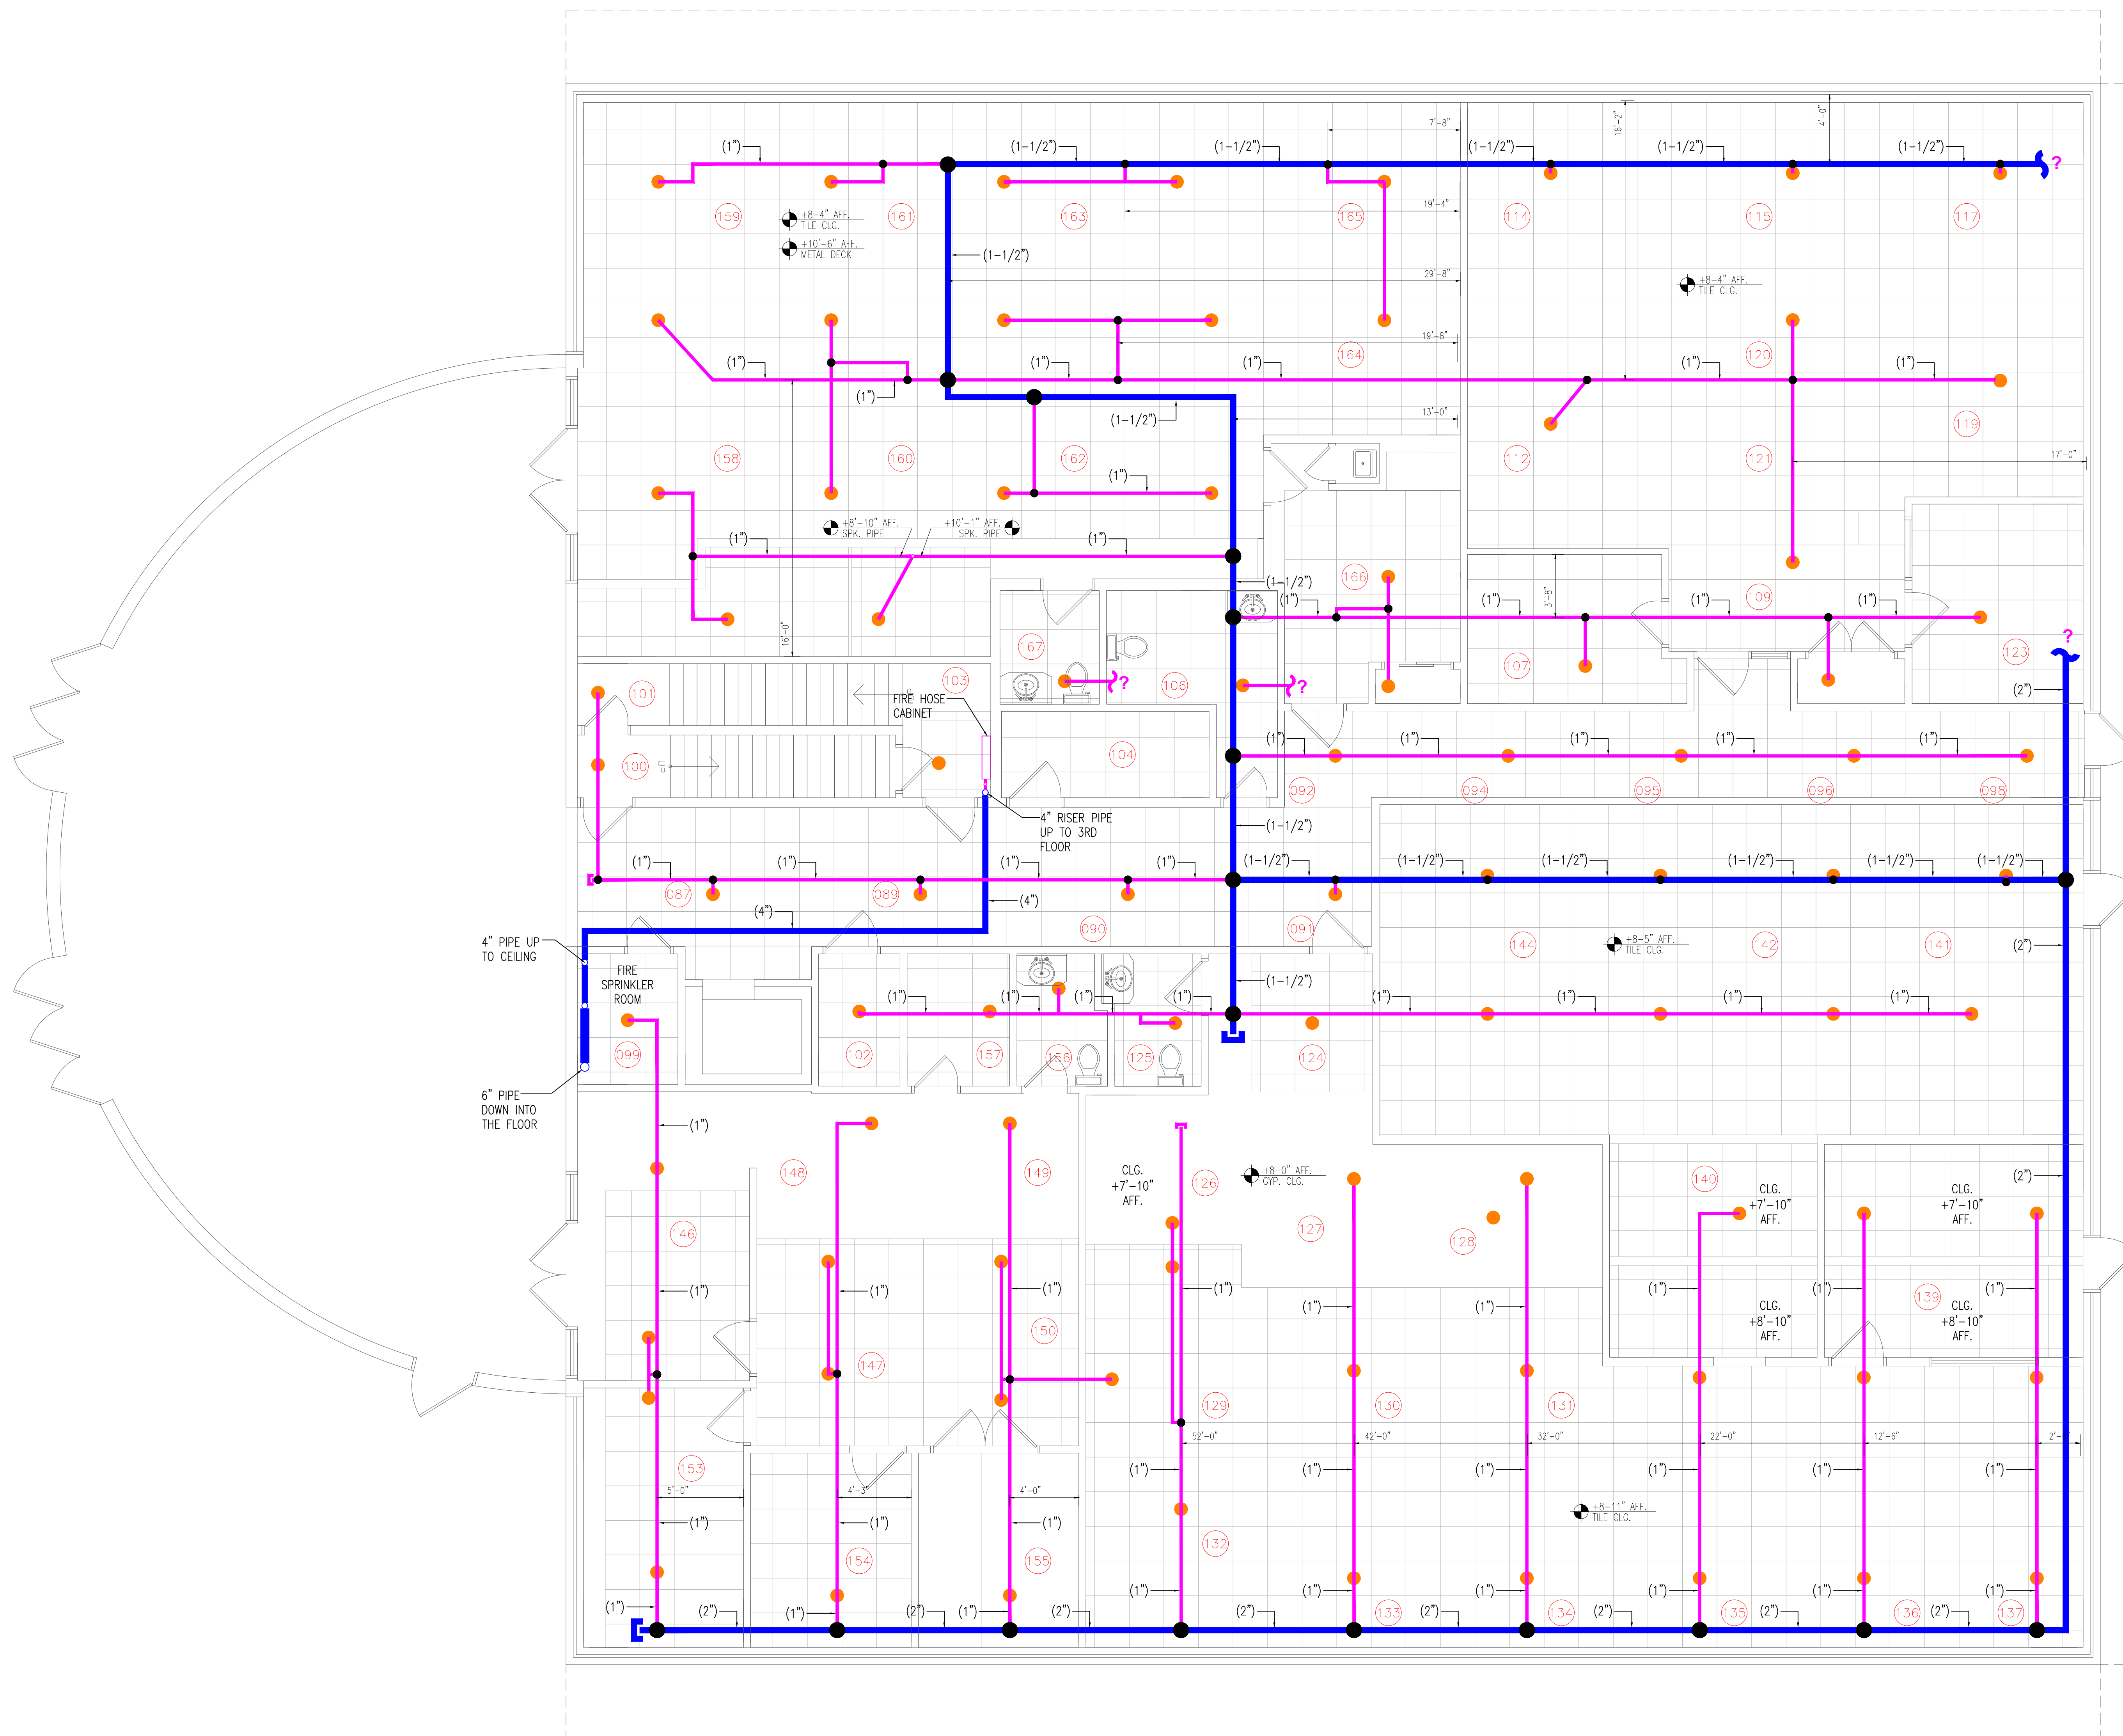

ARCH AS-BUILT
Survey + CAD Designing


Tel: 917-400-3011
archasbuilt@gmail.com
www.archasbuilt.com

DATE:	06/03/20
SURVEYED BY:	IBRAHIM ISMATI
PROJECT NO:	20-0603
SCALE:	N.T.S.
SHEET TITLE:	

EXISTING FIRE SPRINKLER
SYSTEM

SHEET NO:

SP-01

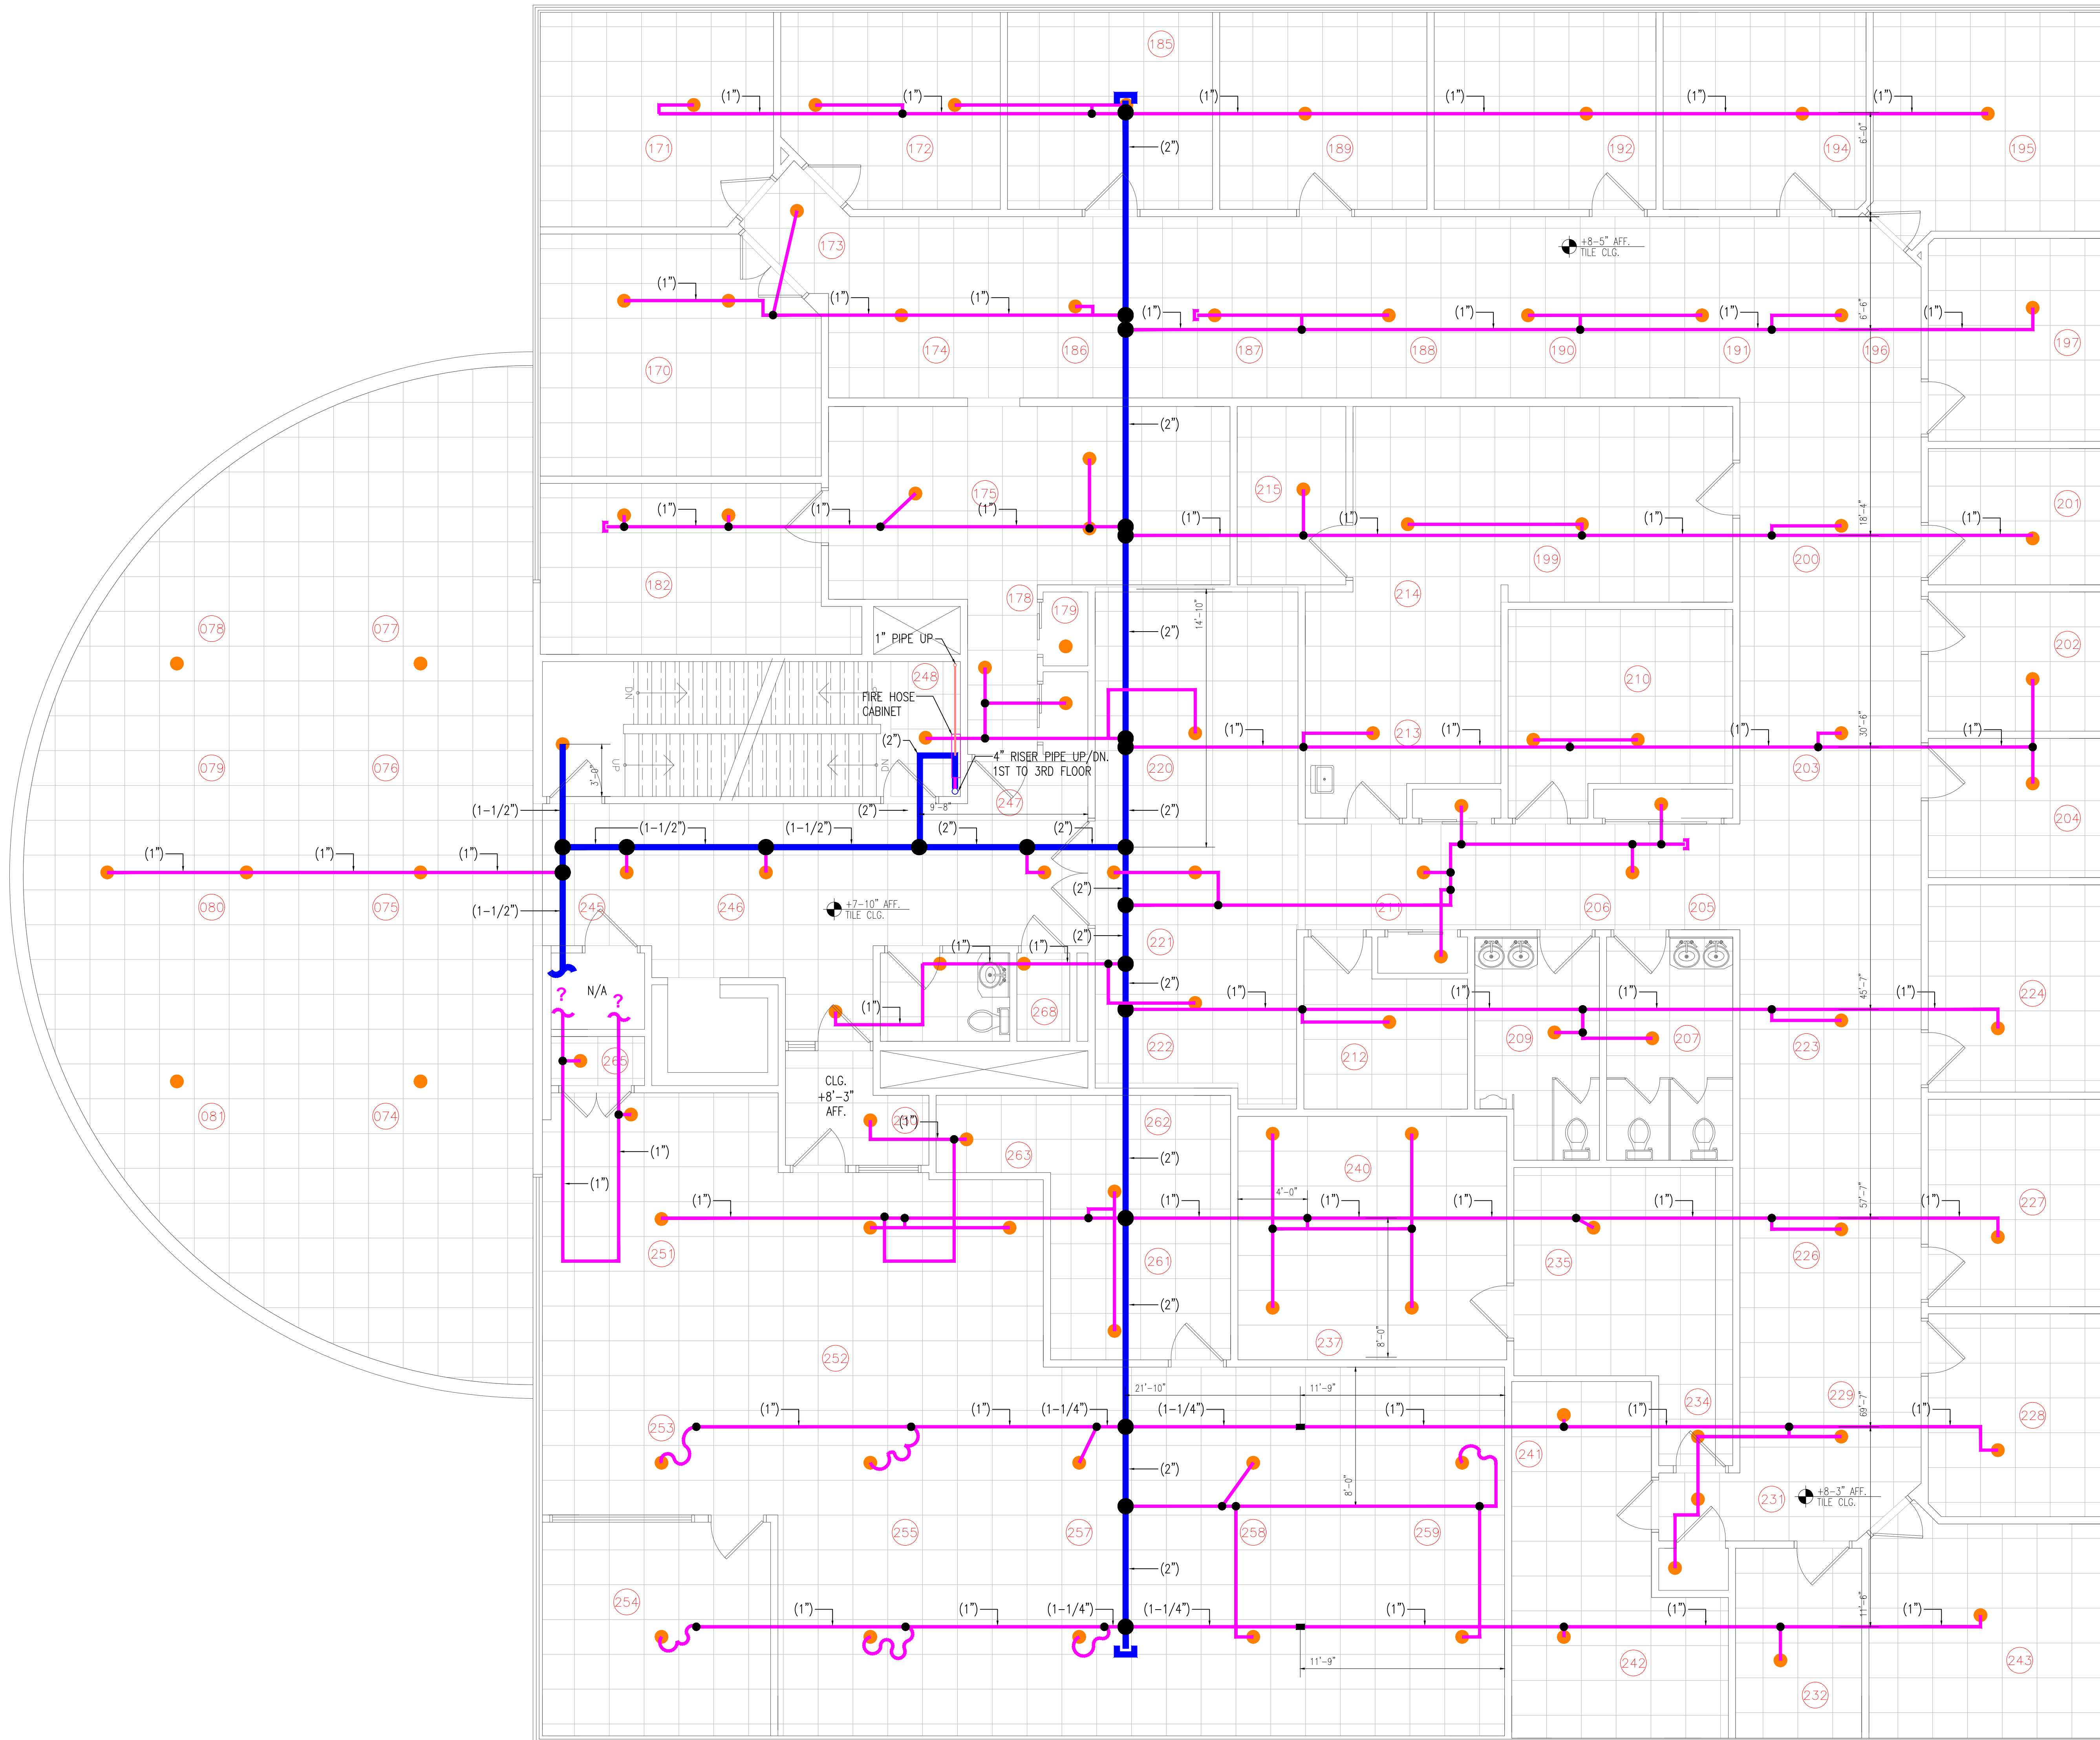

ARCH AS-BUILT
Survey + CAD Designing


Tel: 917-400-3011
archasbuilt@gmail.com
www.archasbuilt.com

DATE:	06/03/20
SURVEYED BY:	IBRAHIM ISMATI
PROJECT NO:	20-0603
SCALE:	N.T.S.
SHEET TITLE:	

EXISTING FIRE SPRINKLER
SYSTEM

SHEET NO:

SP-02

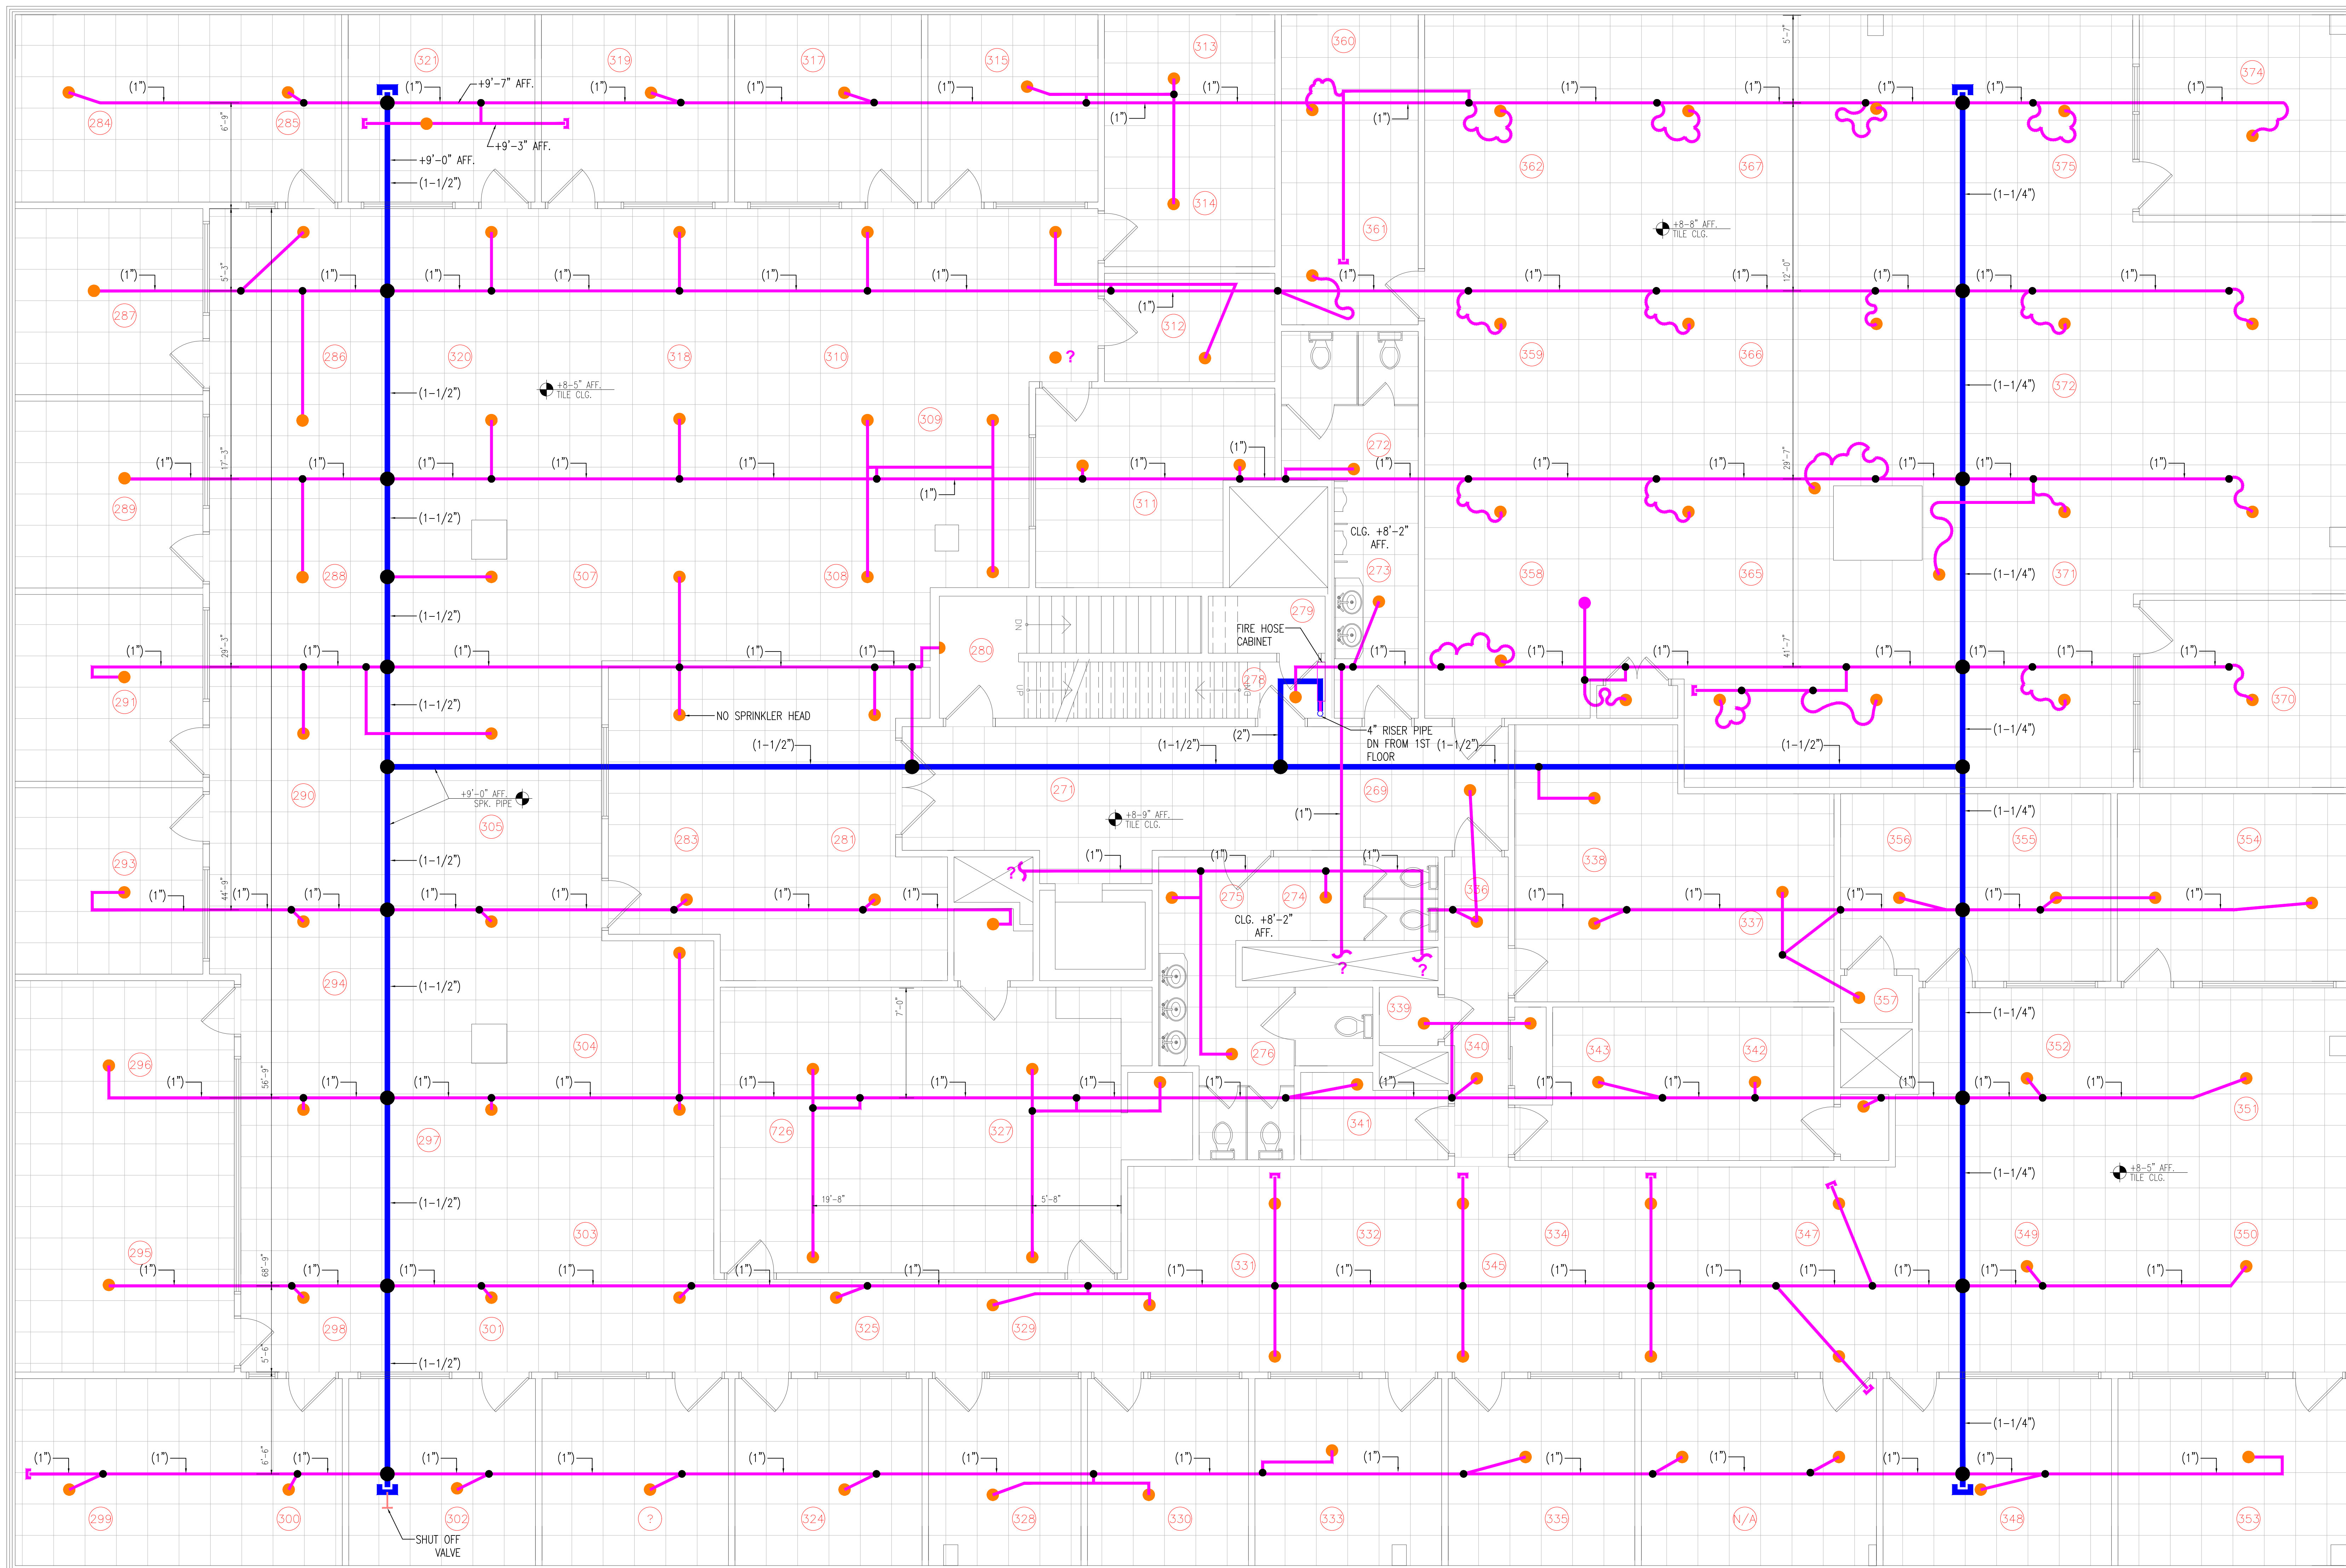

ARCH AS-BUILT
Survey + CAD Designing

Tel: 917-400-3011
archasbuilt@gmail.com
www.archasbuilt.com

DATE:	06/03/20
SURVEYED BY:	IBRAHIM ISMATI
PROJECT NO.:	20_0603
SCALE:	N.T.S.
SHEET TITLE:	

EXISTING FIRE SPRINKLER
SYSTEM

SHEET NO.:

SP-03